

NOTICE - The last day for appealing this decision is May 19, 1989

Committee of Adjustment

DECISION OF COMMITTEE WITH REASONS RE APPLICATION FOR MINOR VARIANCE

Planning Act, 1983, c. 1, ss. 44 (8)

(a) Name of committee (a) ~~Committee of Adjustment of the Corporation of the Town of Orangeville~~

(b) Name of applicant RE AN APPLICATION BY (b) Ontario Hydro

(c) Brief description LOCATION OF PROPERTY (c) ~~Part of Lots 21 to 29, R.P. 222.~~

(d) As set out in application PURPOSE OF APPLICATION (d) ~~Permission to Extend or Enlarge a Legal Non-conforming Use on the property described as Part of Lots 21 to 29, R.P. 222, Town of Orangeville, known municipally as 70 Third Street.~~

WE, the undersigned, in making the decision upon this application have considered whether or not the variance requested was minor and desirable for the appropriate development and use of the land and that the general intent and purpose of the zoning by-law and the official plan will be maintained, or in the case of a change in a use of property which is lawfully non-conforming under the by-law as to whether or not this application has met the requirements of section 44 (2) of the *Planning Act*,

(e) Date of decision CONCUR in the following decisions and reasons for decisions made on the (e) 19th day of April 1989.

DECISION:

The matter of an application by Ontario Hydro, 93 Bell Farm Road, Barrie, Ontario, for permission to Extend or Enlarge a Legal Non-conforming Use on the property described as Part of Lots 21 to 29, Registered Plan 222, Town of Orangeville, known municipally as 70 Third Street, under the provisions of Section 44 of the Planning Act, S.O. 1983, Chapter 1, BE GRANTED.

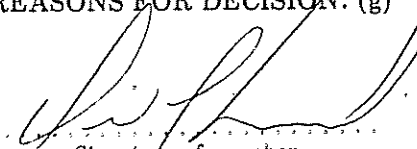
(f) State conditions to be satisfied before granting of consent CONDITIONS - This decision has been made subject to the following conditions: (f)

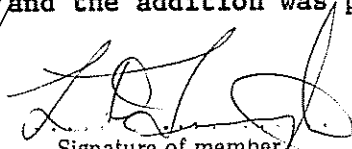
None

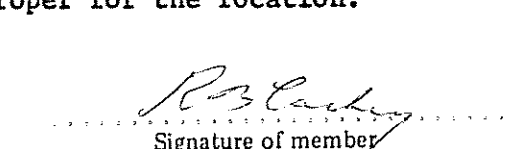
(g) State reasons for decision

REASONS FOR DECISION: (g)

The intent of the Official Plan was being maintained and the addition was proper for the location.


Signature of member of committee.


Signature of member of committee.


Signature of member of committee.

.....
Signature of member of committee.

.....
Signature of member of committee.

.....
Signature of member of committee.

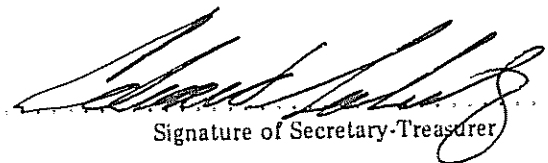
CERTIFICATION

Planning Act, 1983, c. 1, ss. 44 (10)

I, Edward C. Salisbury

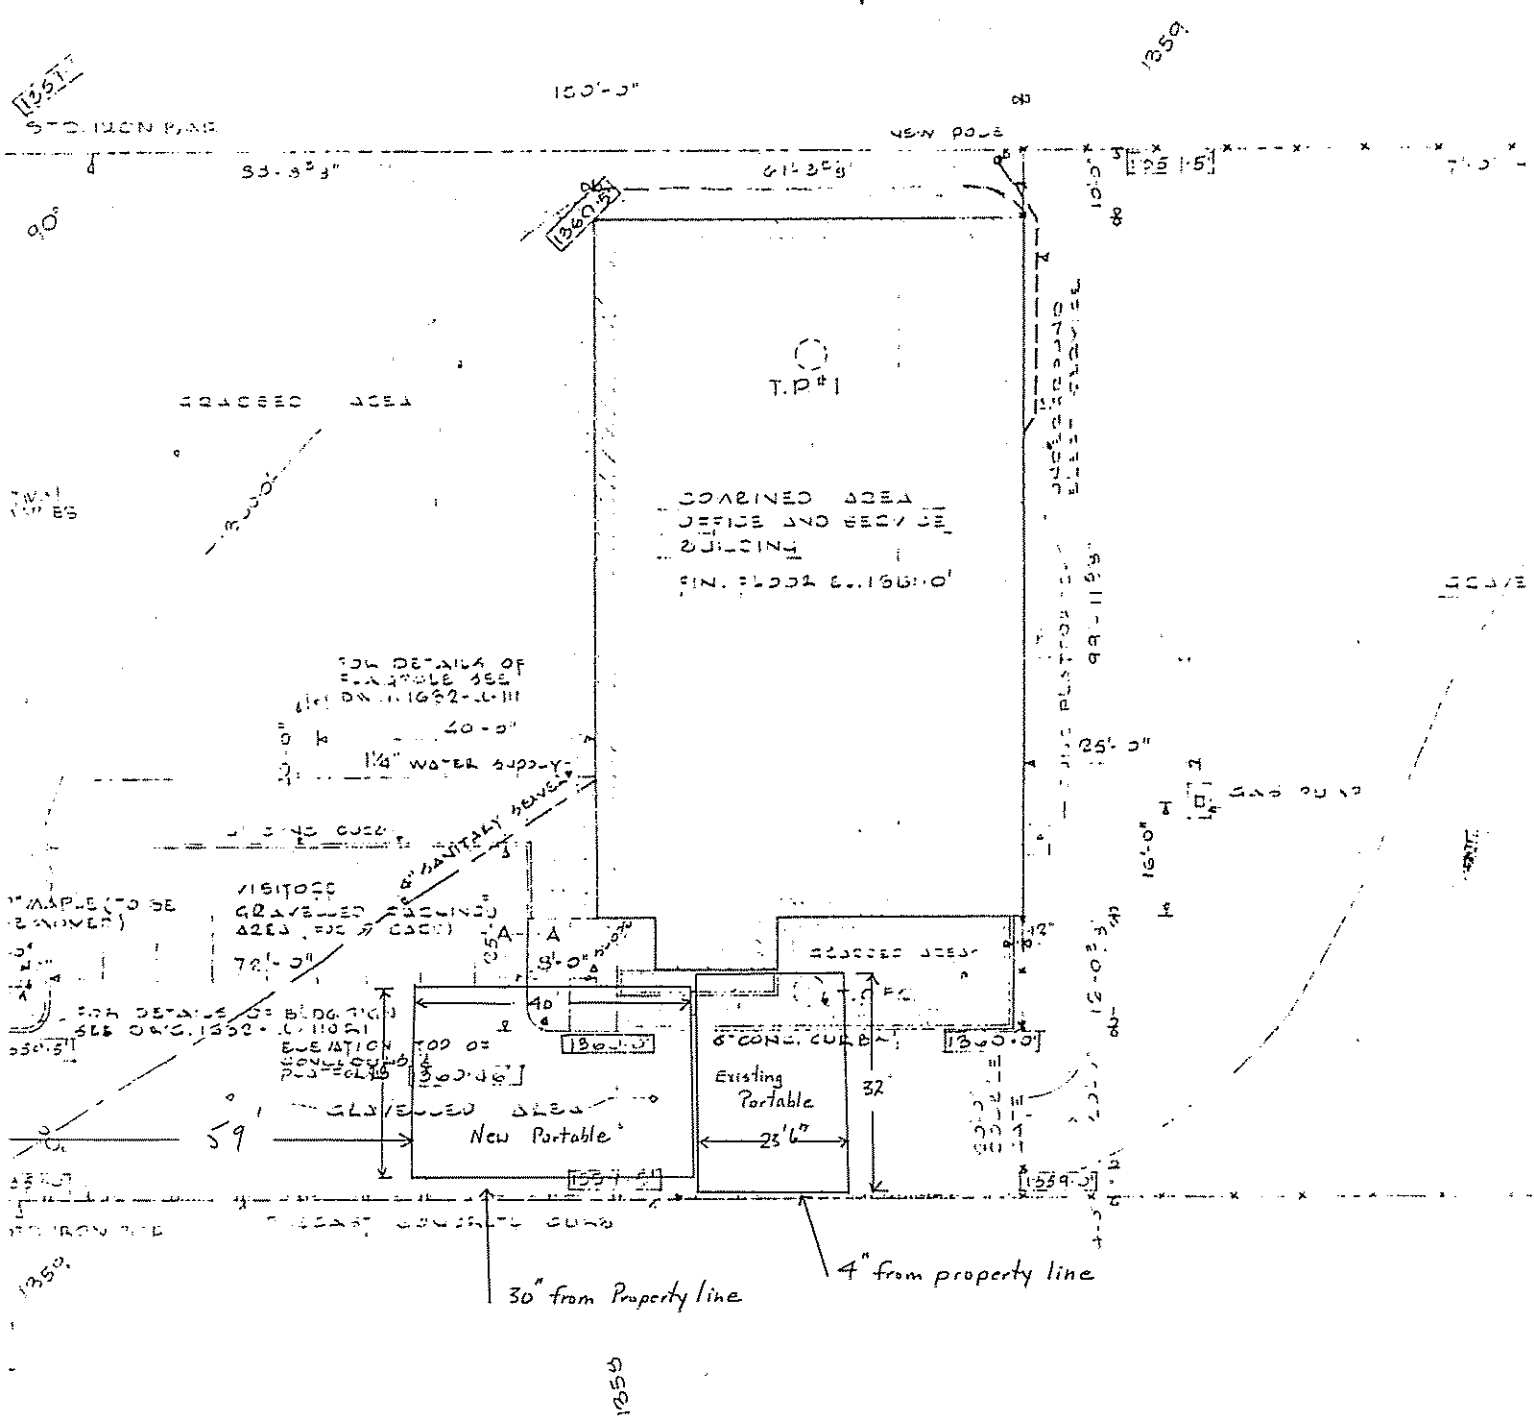
(h) Name of committee Secretary-Treasurer of the (h) Committee of Adjustment for the Corporation of the Town of Orangeville certify that the above is a true copy of the decision of the committee with respect to the application recorded therein.

Dated this 27 day of April 1989

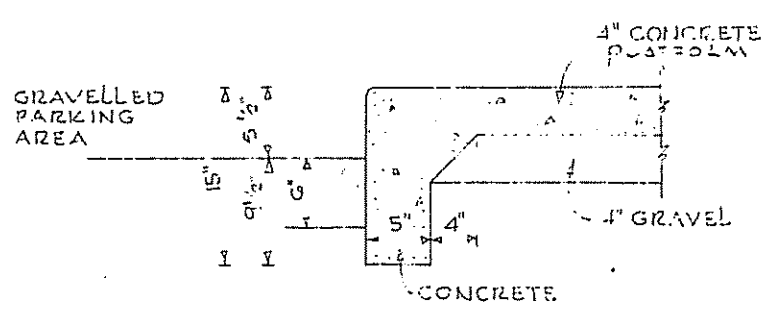

Signature of Secretary-Treasurer

3 W. SERVICE
WIRE FENCE

LOT 21 LOT 22 LOT 23 L
REGISTERED



PROPERTY LINE OF REGISTERED



SECTION A-A THRU CONCRETE WALK
SCALE 1" = 1'-0"

GRANT
FENCE AREA
E. E. 30-00

12"



THE CORPORATION OF THE TOWN OF ORANGEVILLE

MUNICIPAL BUILDING
87 BROADWAY
PHONE 519-941-0440
L9W 1K1

DEPT. COMMITTEE OF ADJUSTMENT

REPLY TO: E.C. Salisbury
Secretary-Treasurer

SUBMISSION NO. A-10/89

THE
COMMITTEE OF ADJUSTMENT
OF THE
TOWN OF ORANGEVILLE

AND

IN THE MATTER OF AN APPLICATION BY Ontario Hydro, 93 Bell Farm Road, Barrie, Ontario, for a permission to Extend or Enlarge a Legal Non-conforming Use on the property described as Part of Lots 21 to 29, Registered Plan 222, Town of Orangeville, known municipally as 70 Third Street, under the provisions of Section 44 of the Planning Act, S.O. 1983, Chapter 1.

NOTICE OF HEARING

THE COMMITTEE OF ADJUSTMENT of the Town of Orangeville hereby appoints the 19th day of April 1989, at the hour of 7:30 o'clock in the afternoon (local time) in the Council Chambers, Municipal Building, 87 Broadway, Orangeville, for the hearing of all parties interested in supporting or opposing this application. In accordance with Ontario Regulation 447/83, written comments are requested and may be delivered to the undersigned prior to the above Hearing date. If you do not attend or are not represented at this Hearing, the Committee may proceed in your absence and you will not be entitled to any further notice of the proceedings.

Edward C. Salisbury,
Secretary-Treasurer,
Committee of
Adjustment

DATED AT ORANGEVILLE, THIS 4TH DAY OF APRIL, 1989.

Explanatory note: The applicant wishes to obtain the permission of the Committee of Adjustment to locate a portable approximately 27.5 feet by 40 feet at the south end of the existing building. The subject property is zoned M1 - General Industrial under By-law No. 60-77 of the Town of Orangeville, and is designated Industrial in the Official Plan.